

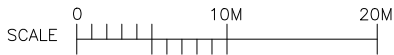


AFFIX	AMENDMENT	DATE
A B	SITE RED LINE BOUNDARY REVISED SITE PLAN REVISED	24.04.18 26.03.20

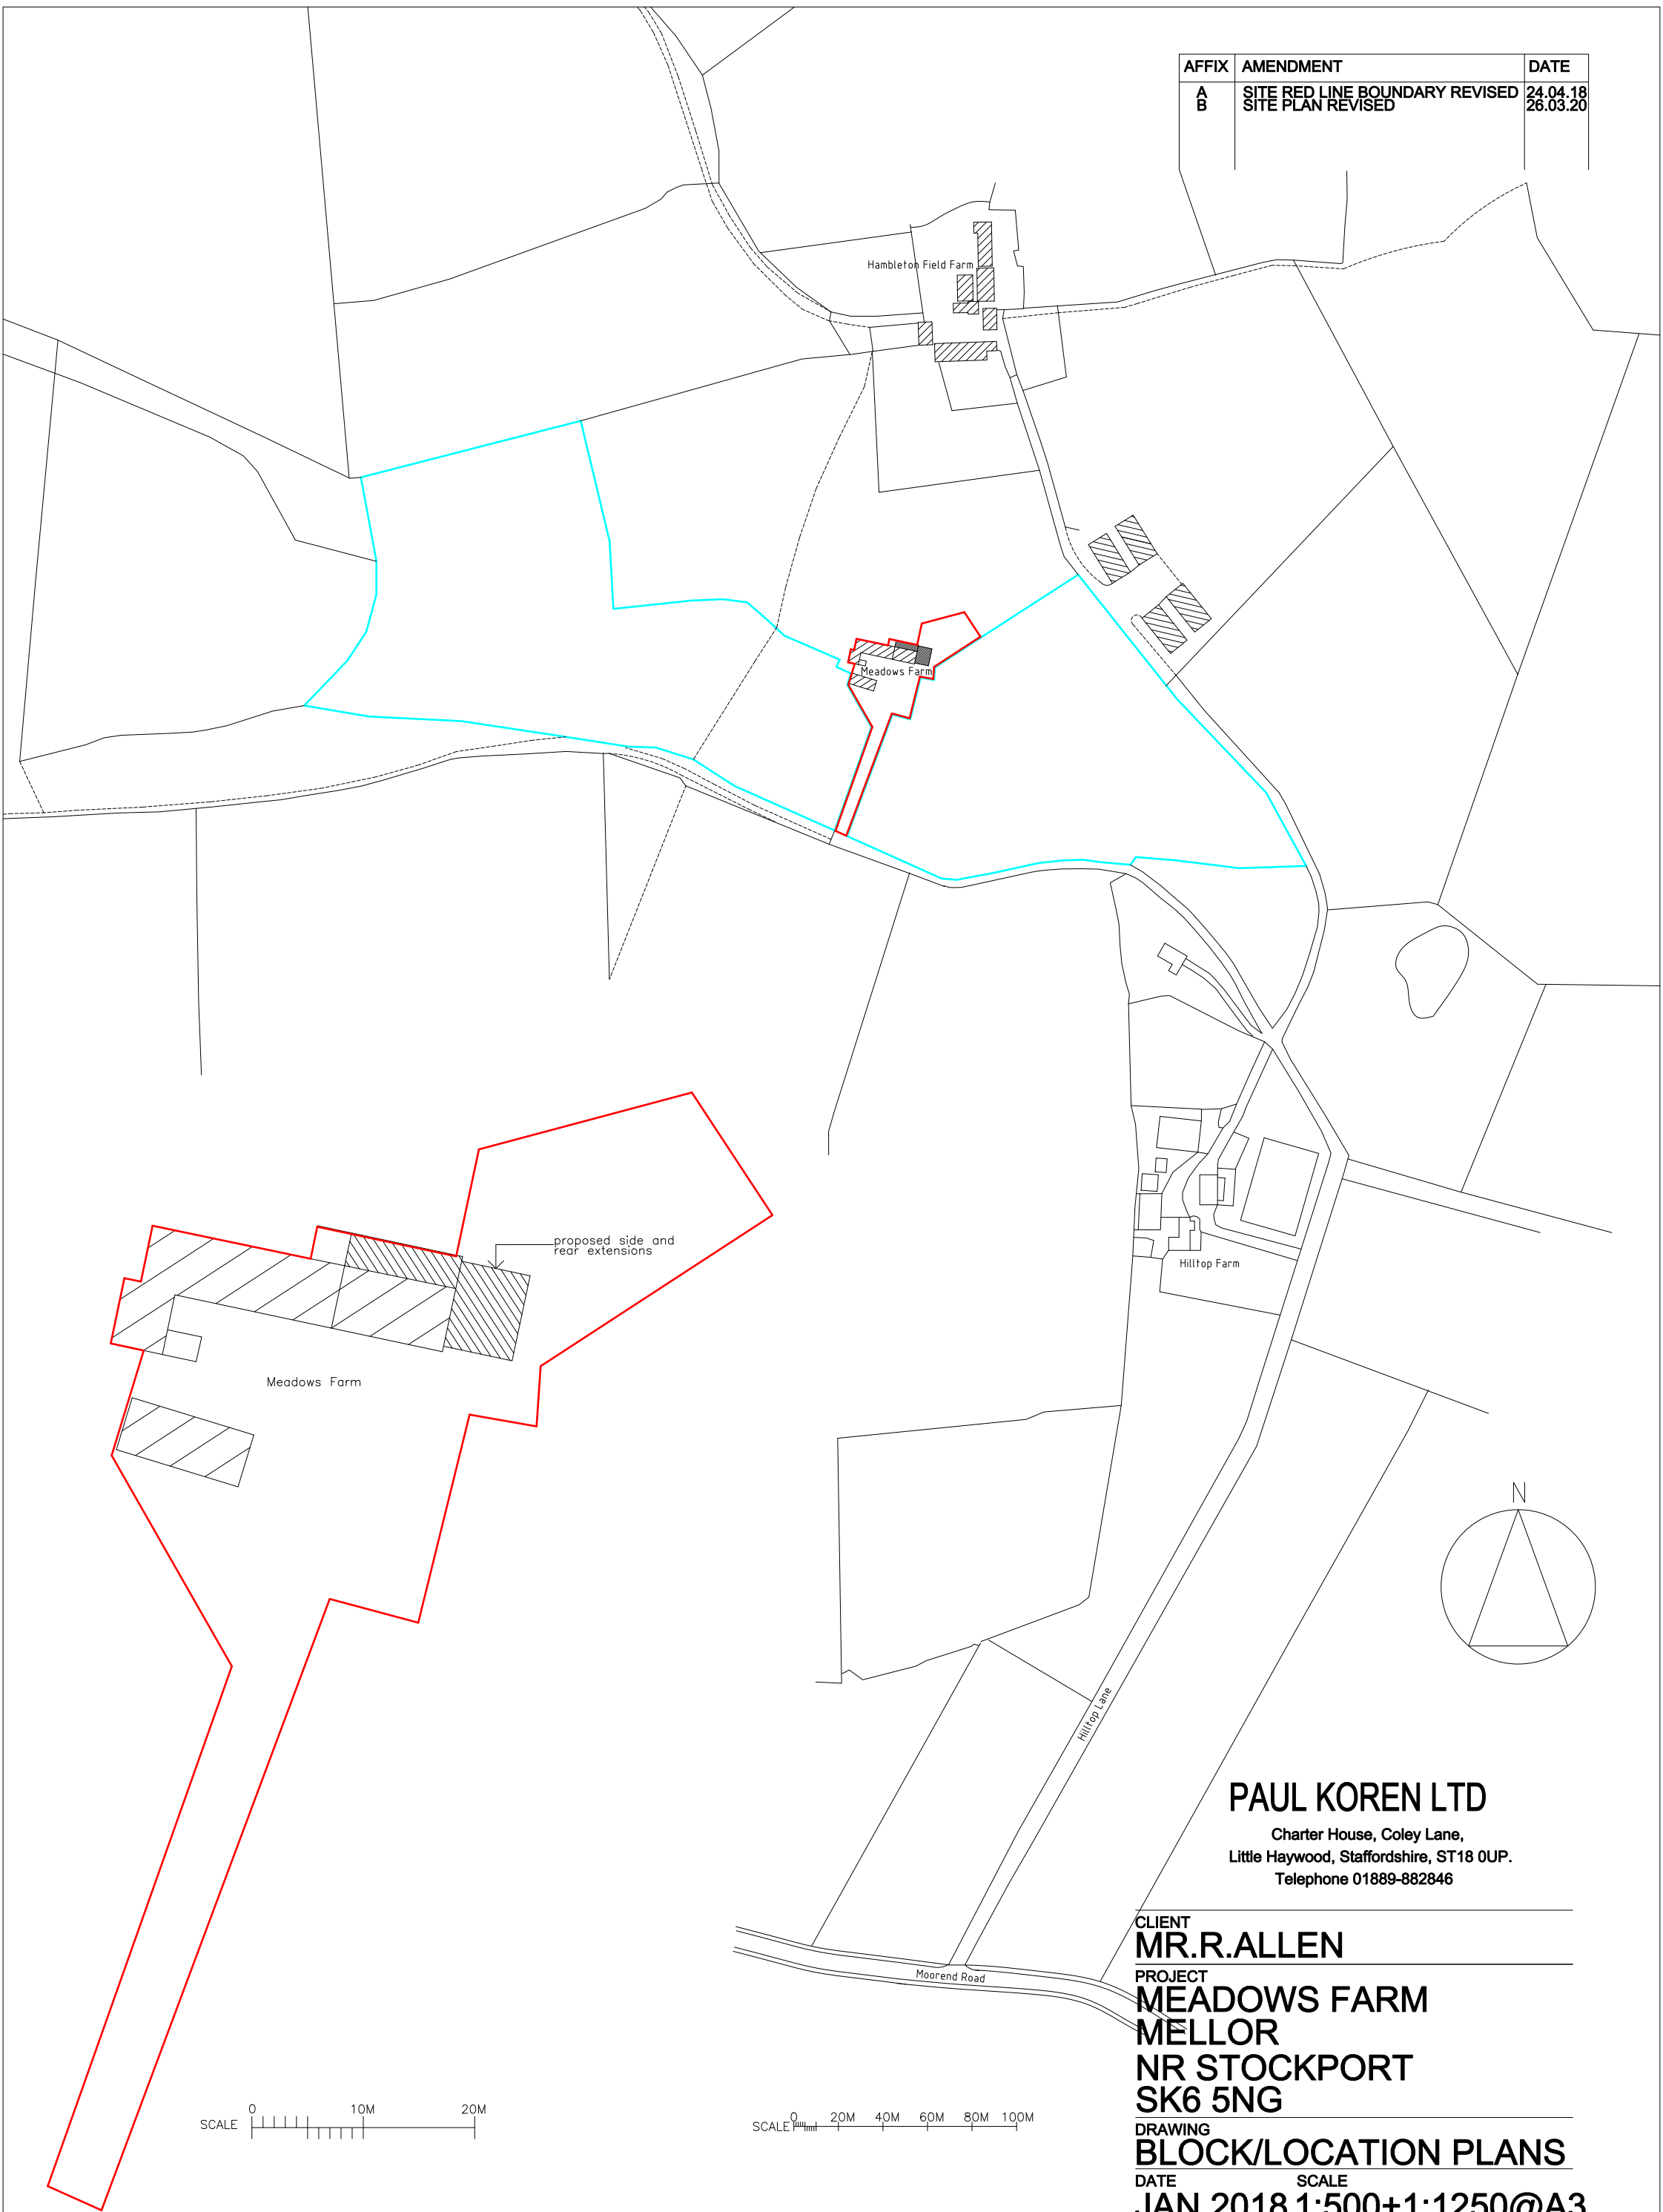

BLOCK PLAN
SCALE 1:500

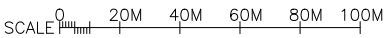

LOCATION PLAN
SCALE 1:2500

PAUL KOREN LTD
Charter House, Coley Lane,
Little Haywood, Staffordshire, ST18 0UP.
Telephone 01889-882846

CLIENT
MR.R.ALLEN

PROJECT
**MEADOWS FARM
MELLOR
NR STOCKPORT
SK6 5NG**

DRAWING
BLOCK/LOCATION PLANS


DATE
JAN 2018

SCALE
1:500+1:1250@A3

NUMBER
0782 - 53

AMENDMENT
B

AFFIX	AMENDMENT	DATE
A	VOLUME OF EXTENSIONS REDUCED	14.04.18
B	FULL PLAN OF EXISTING LEAN-TO	24.04.18
C	RETAINED REVISIONS TO PROPOSALS	26.03.20

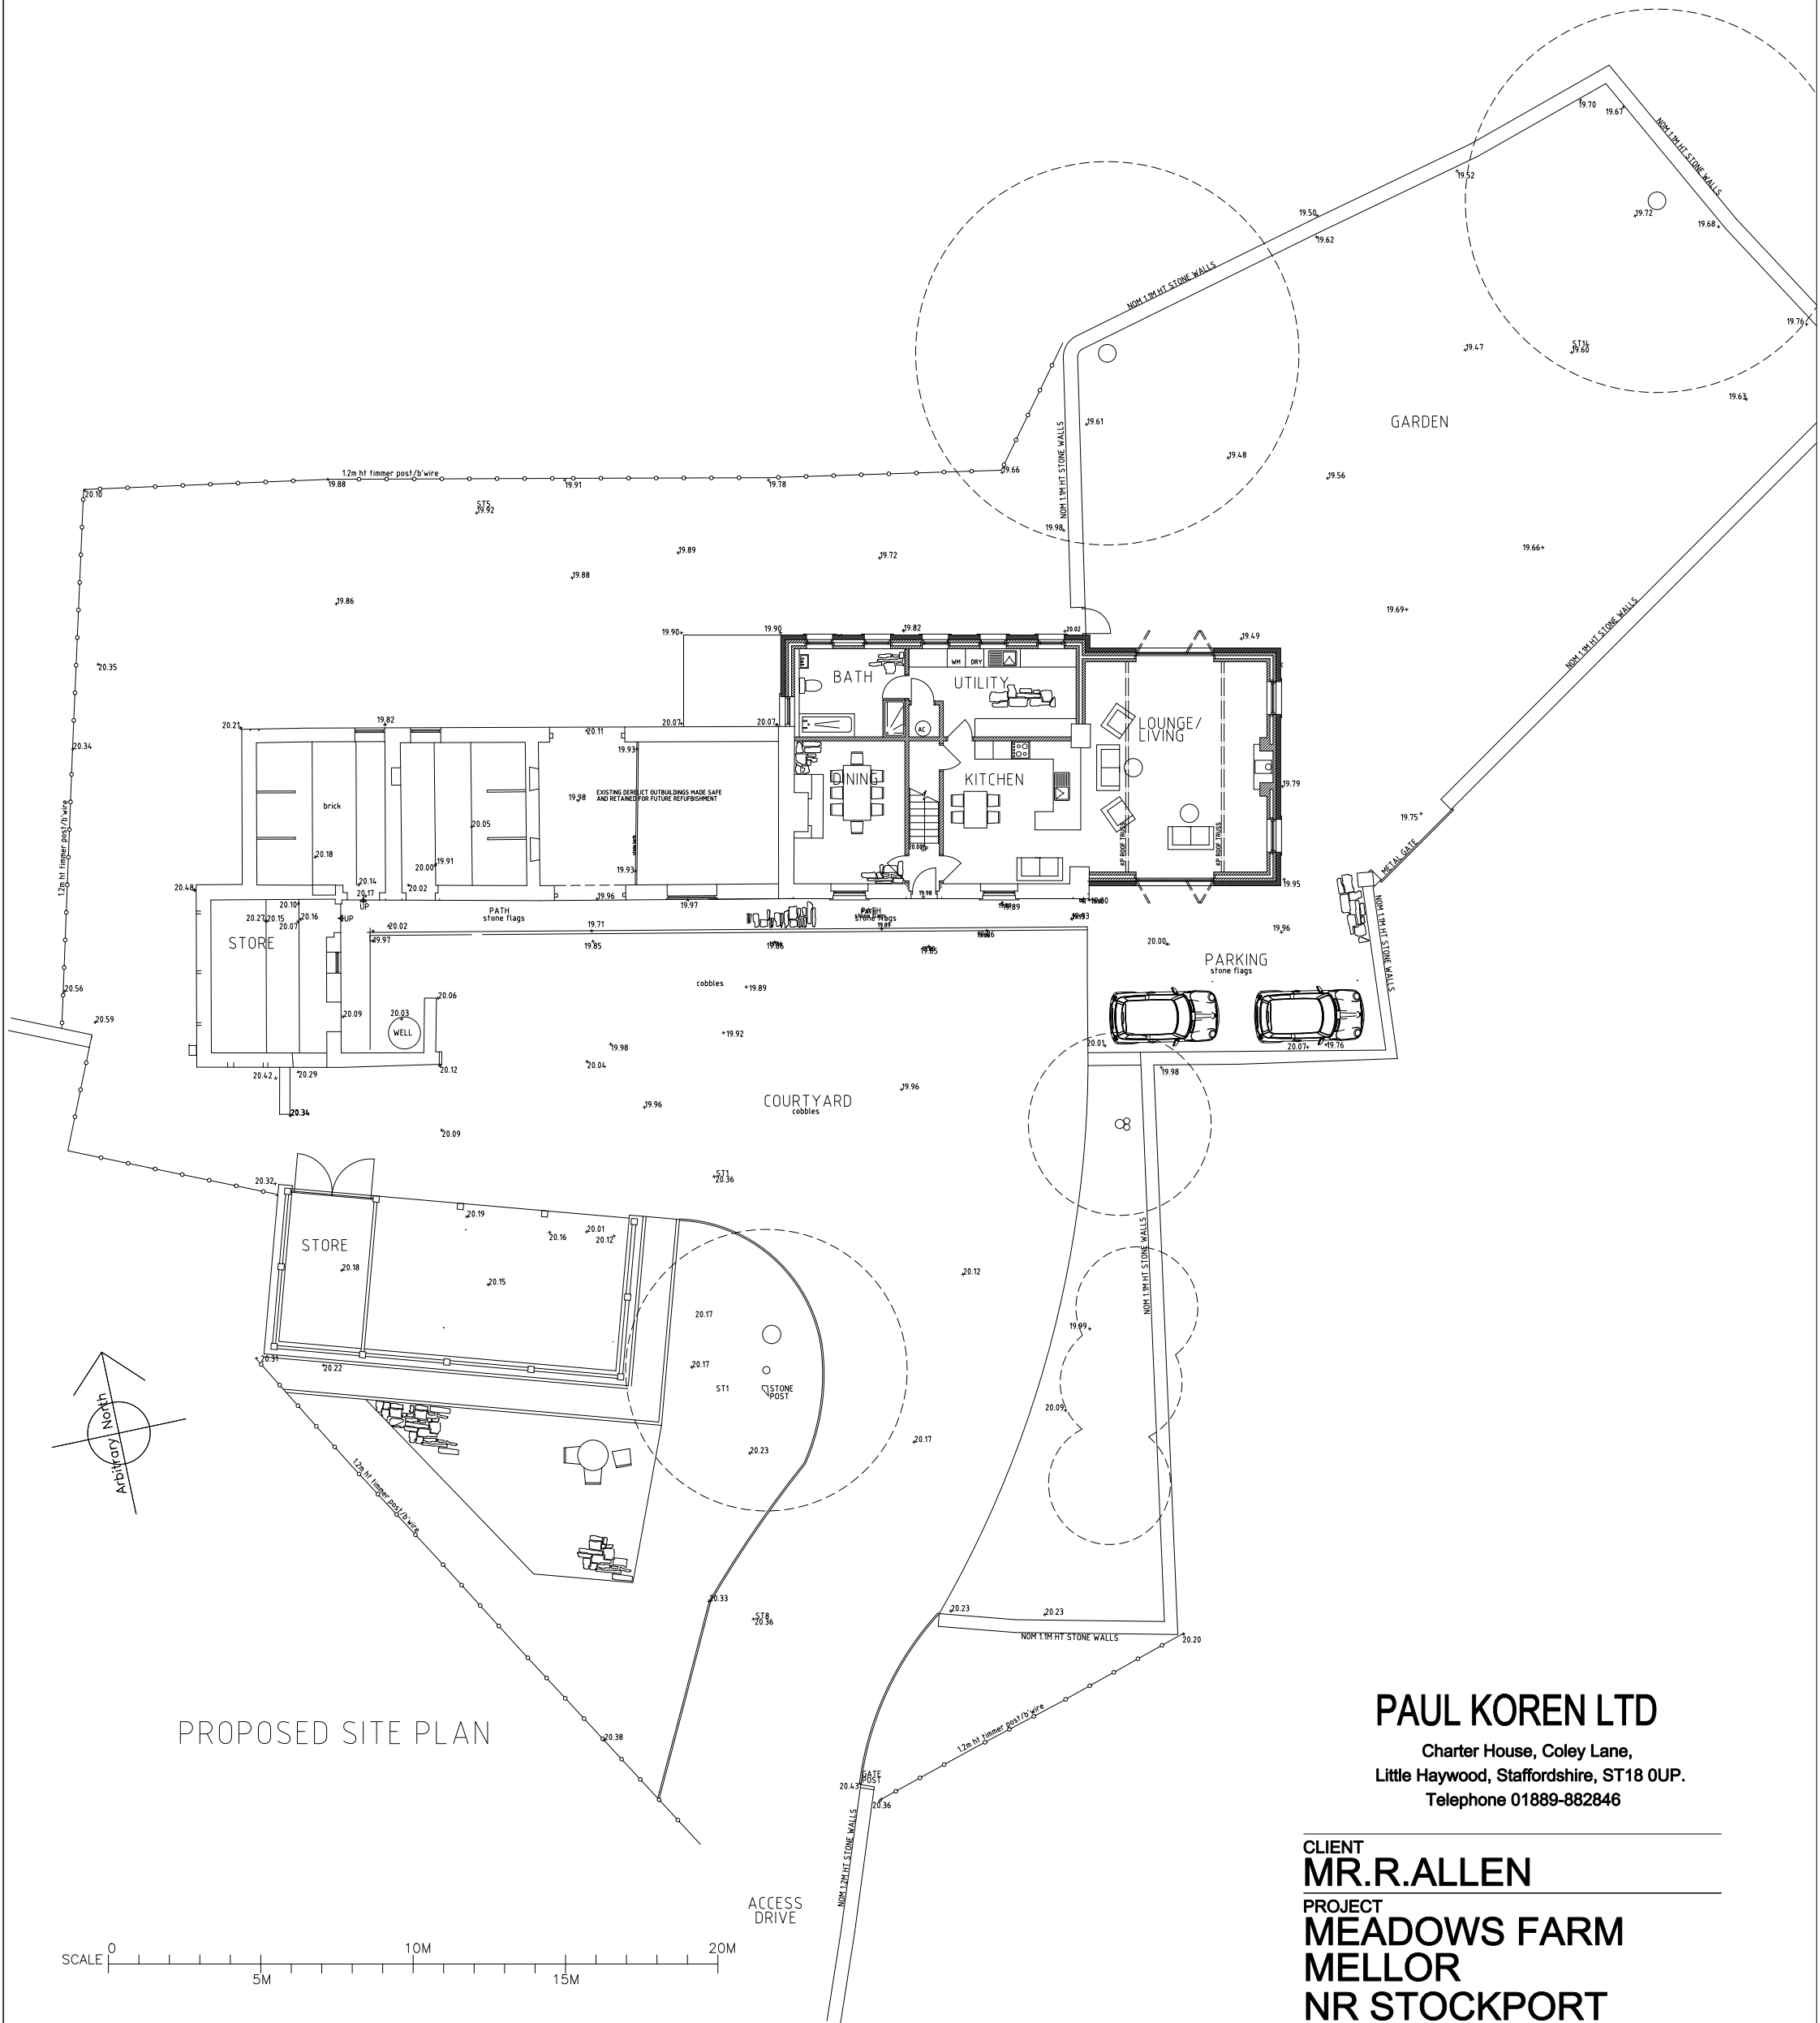

PAUL KOREN LTD

Charter House, Coley Lane,
Little Haywood, Staffordshire, ST18 0UP.
Telephone 01889-882846

CLIENT
MR.R.ALLEN

PROJECT
MEADOWS FARM
MELLOR
NR STOCKPORT
SK6 5NG






DRAWING
SITE PLAN

DATE
JAN 2018

NUMBER
0782 - 52



SCALE
1:200@A3

AMENDMENT
C

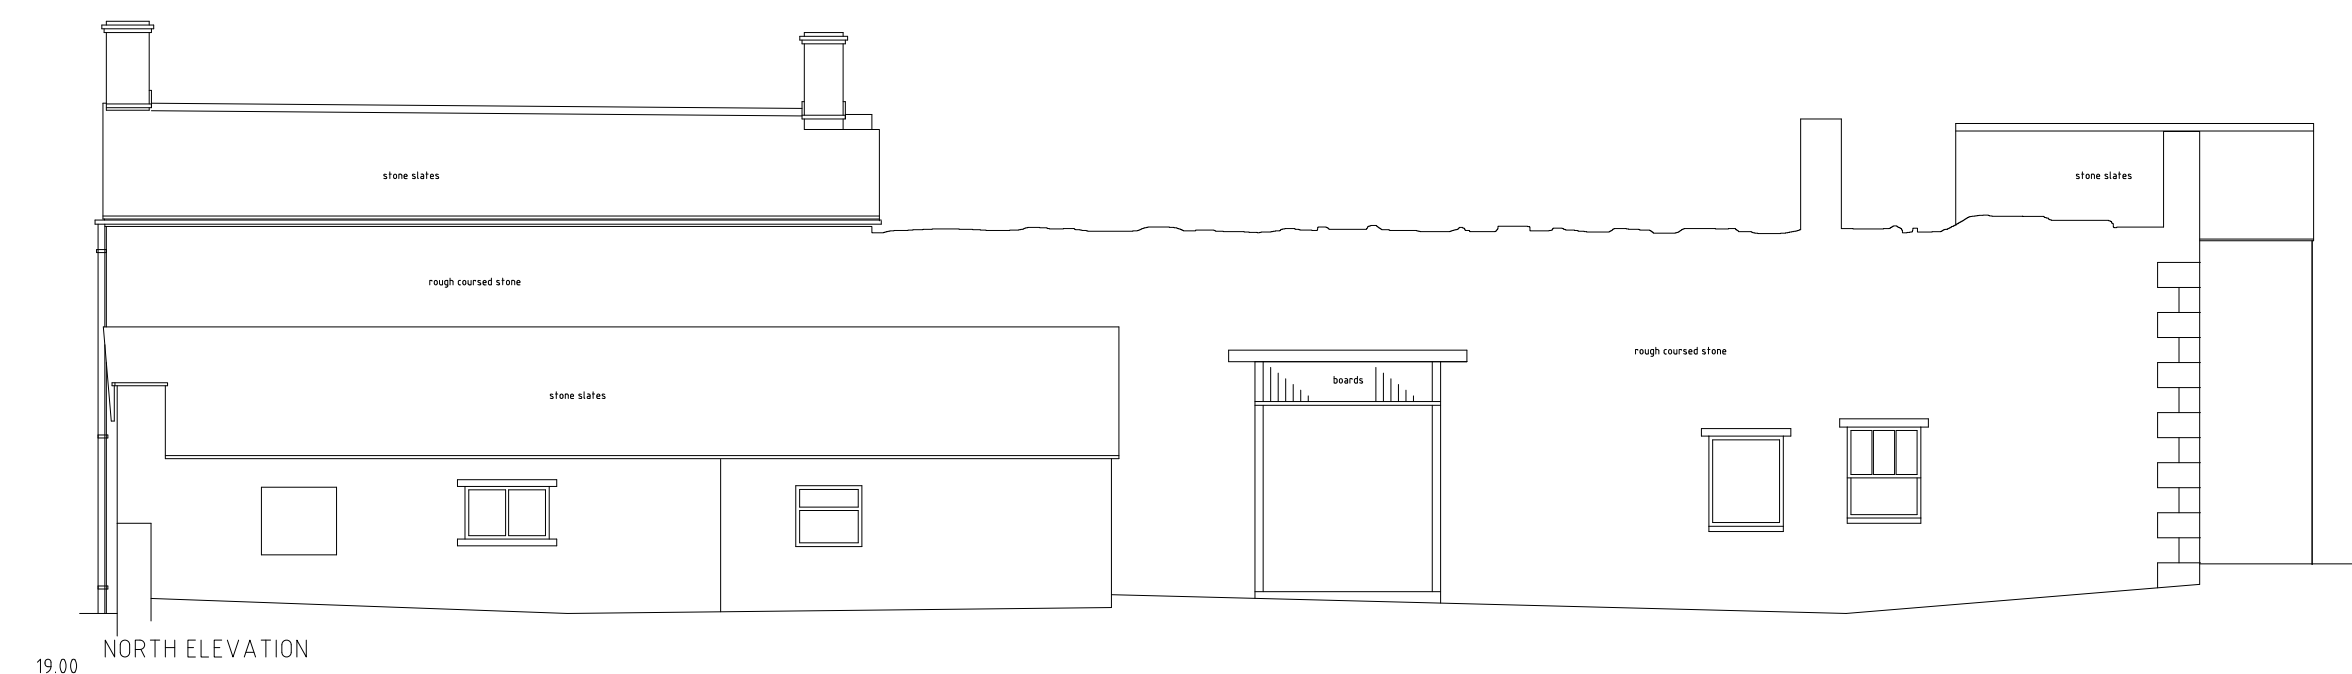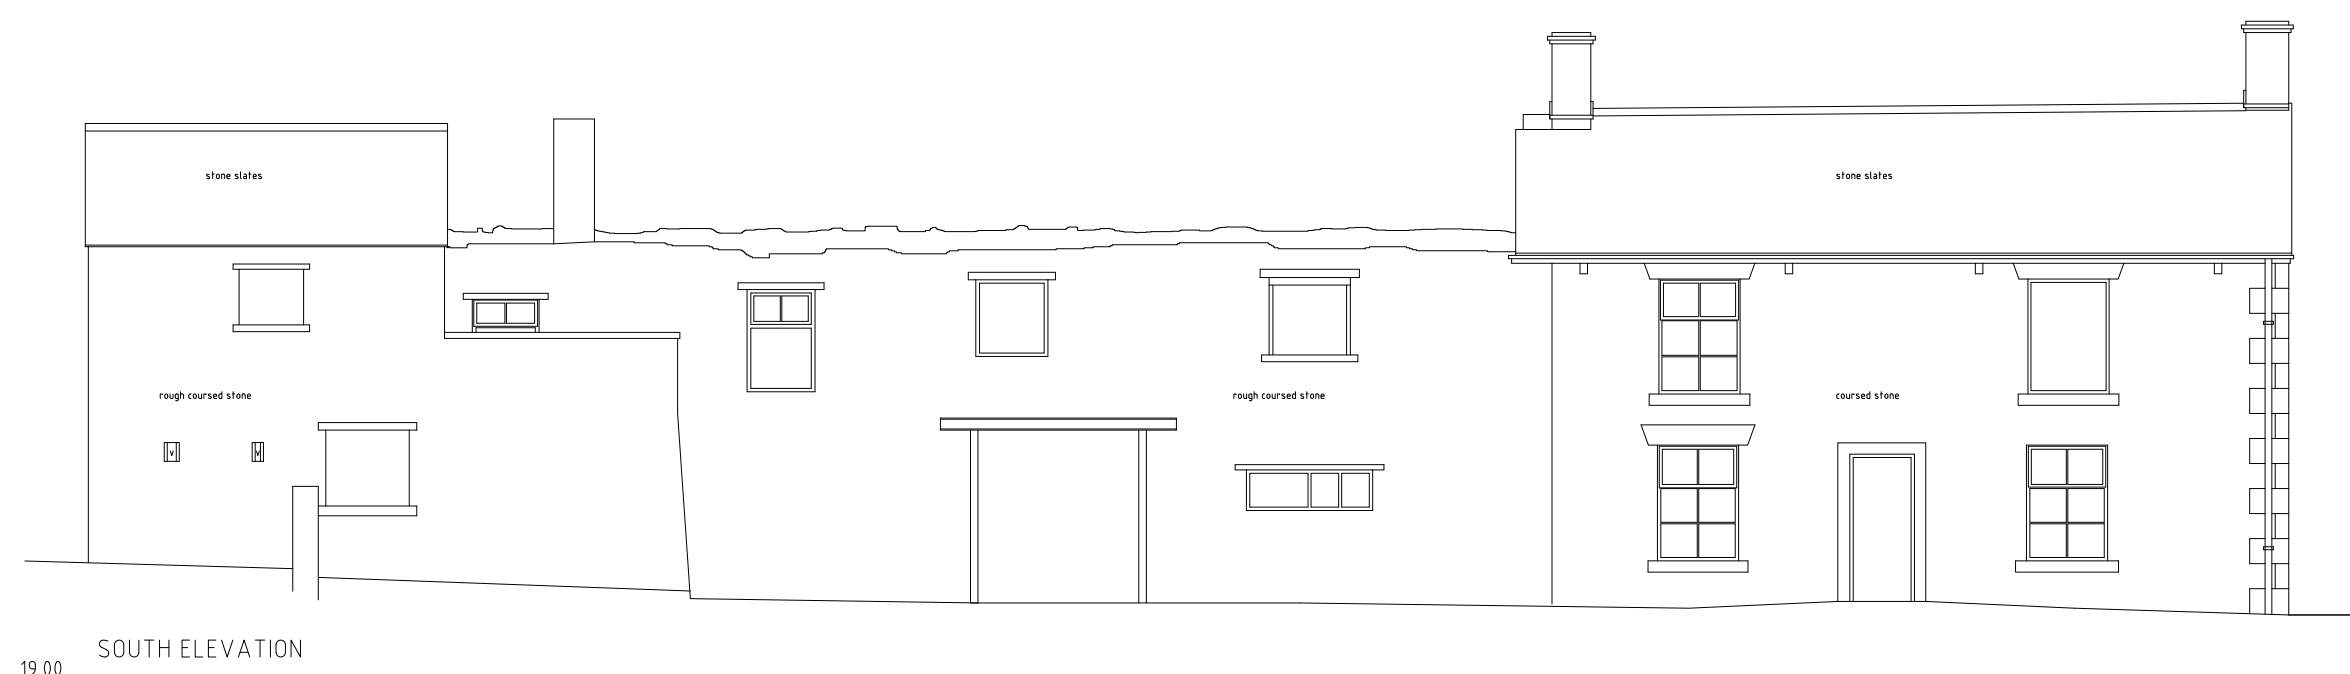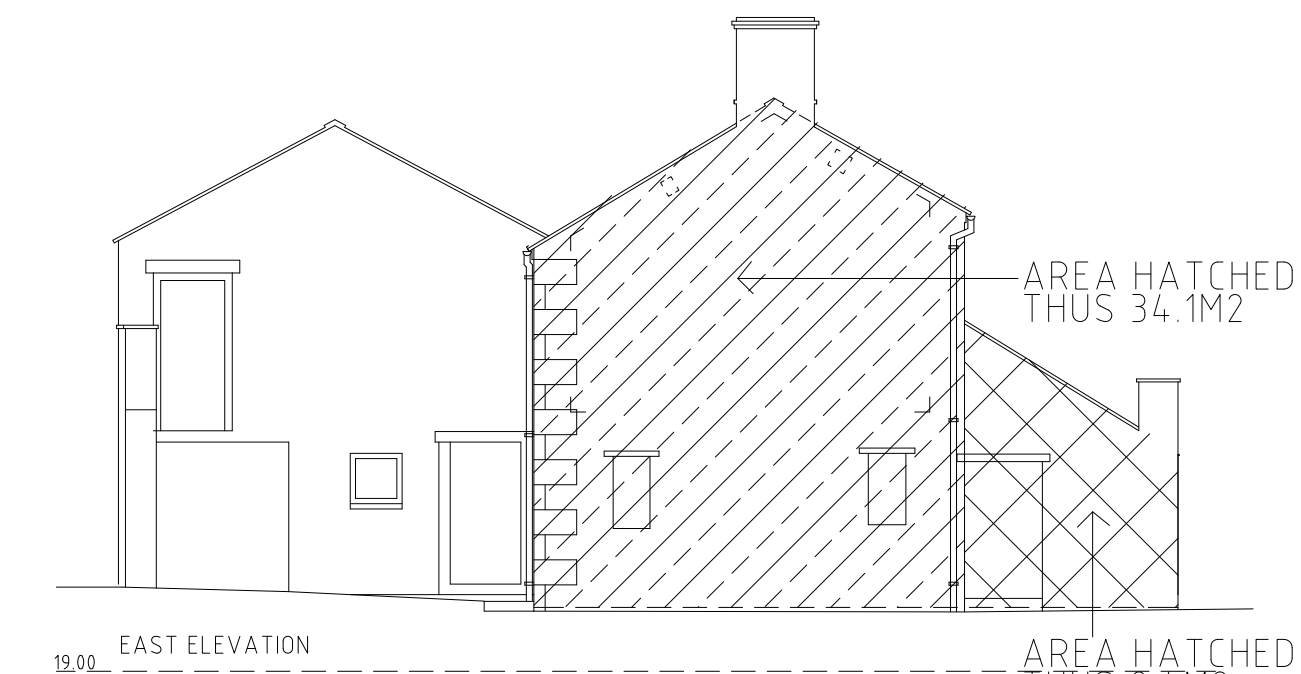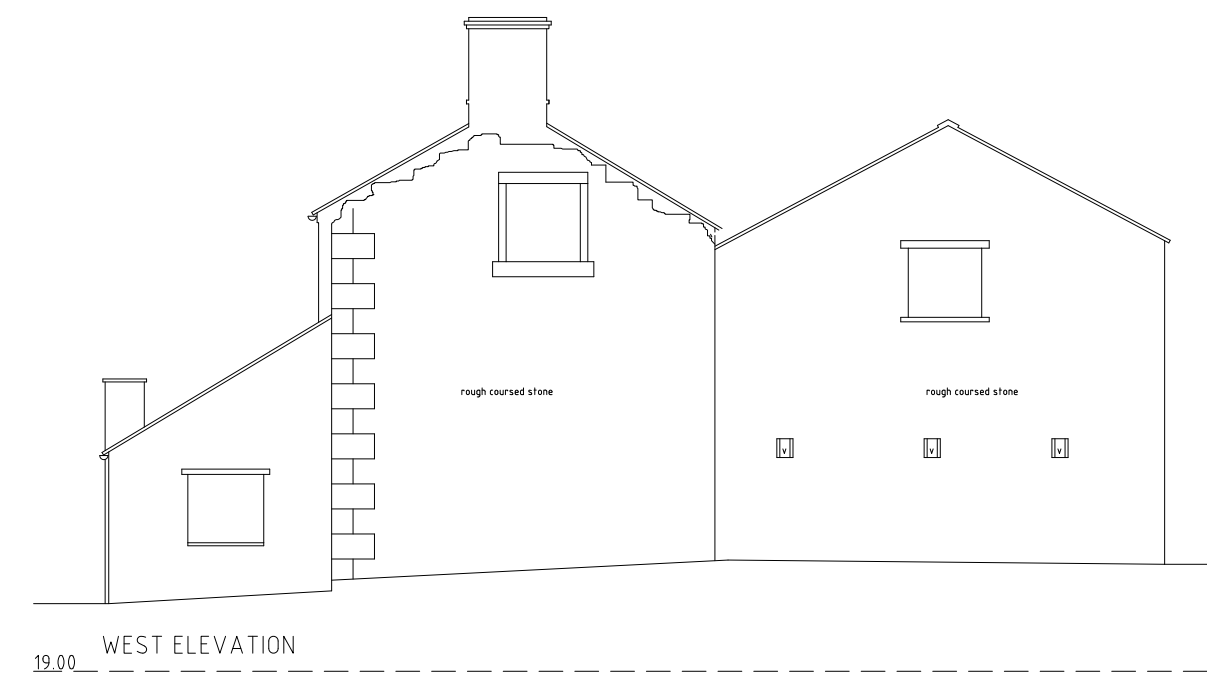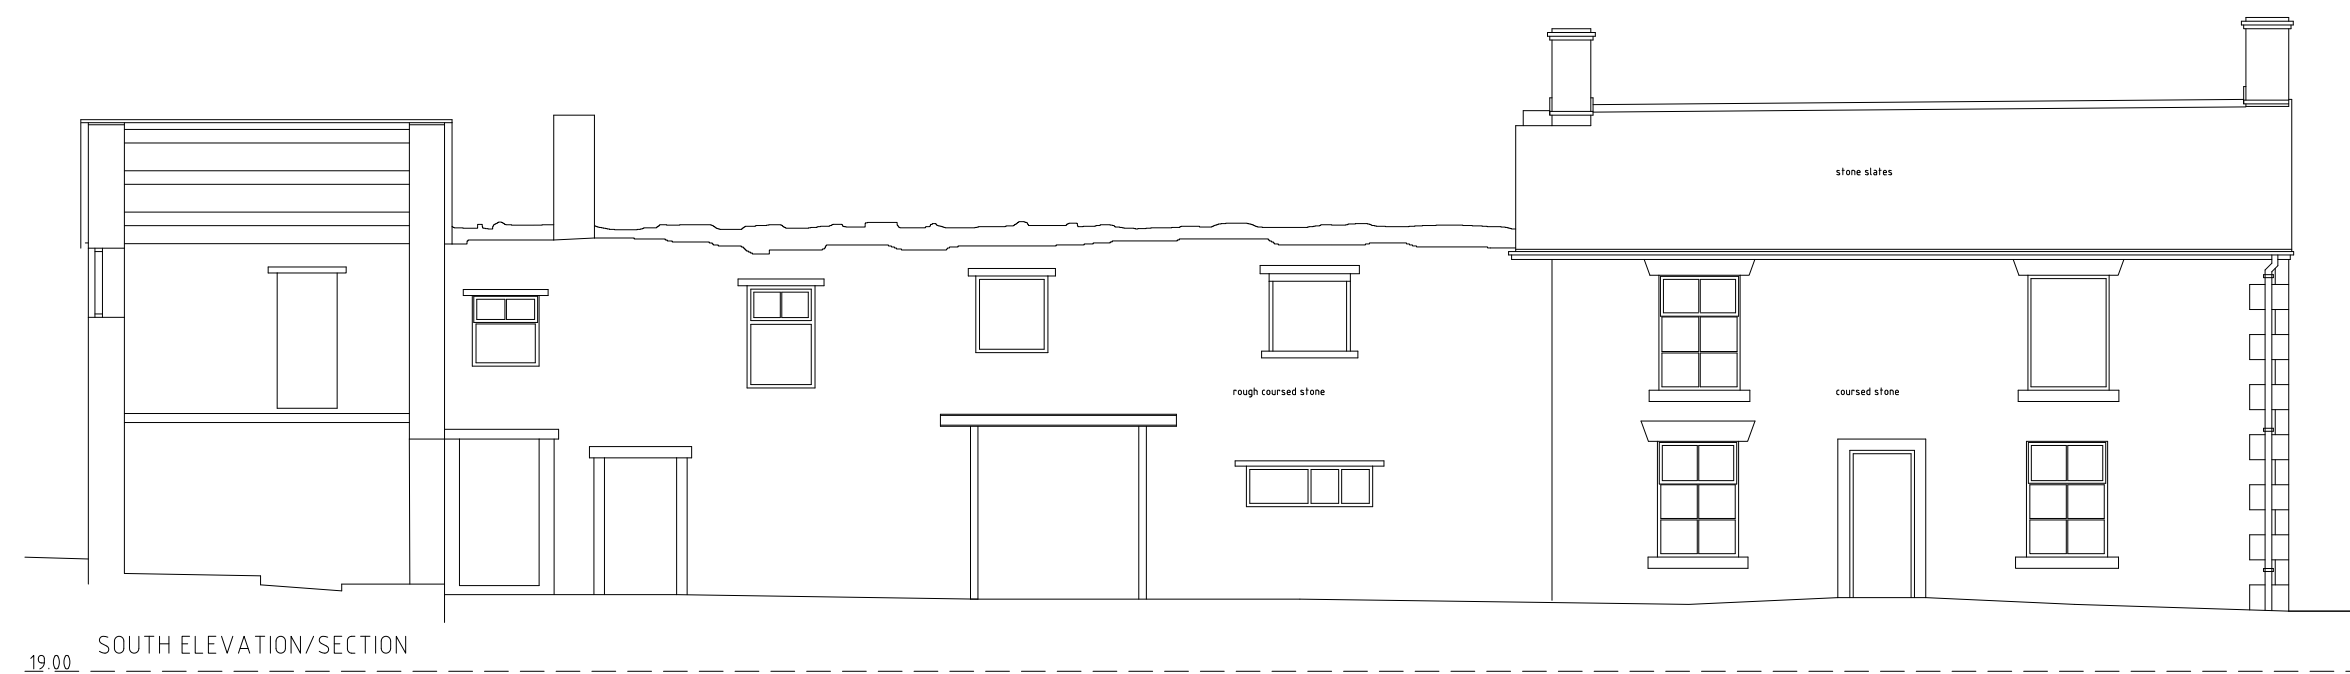

VOLUME CALCULATIONS




VOLUME OF TWO STOREY	$10.2 \times 34.1 = 347.8\text{m}^3$
VOLUME OF SINGLE STOREY	$13.4 \times 8.4 = 112.5\text{m}^3$
TOTAL VOLUME OF EXISTING	460.3m^3

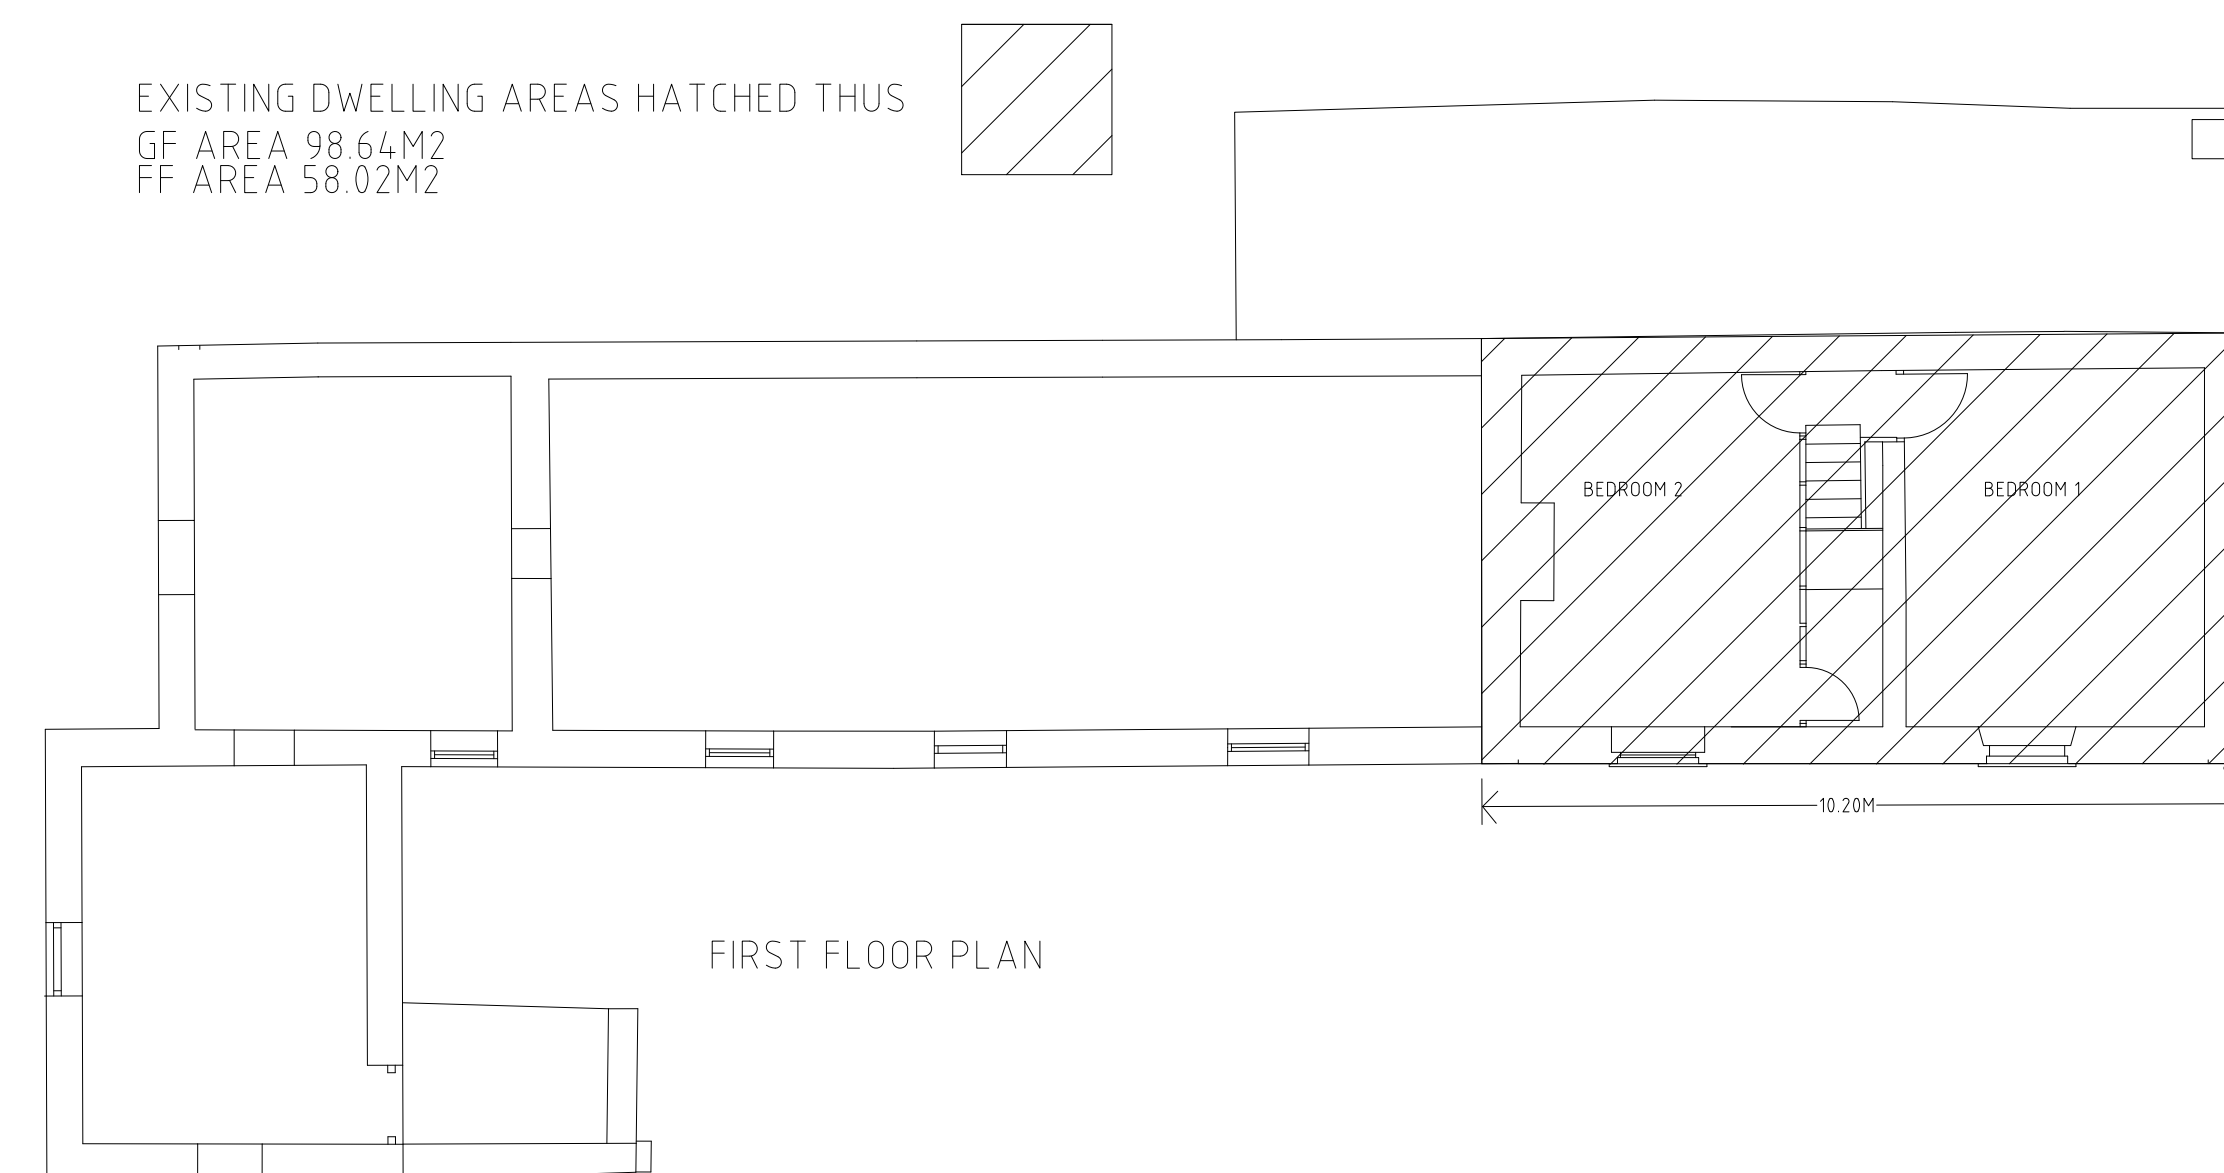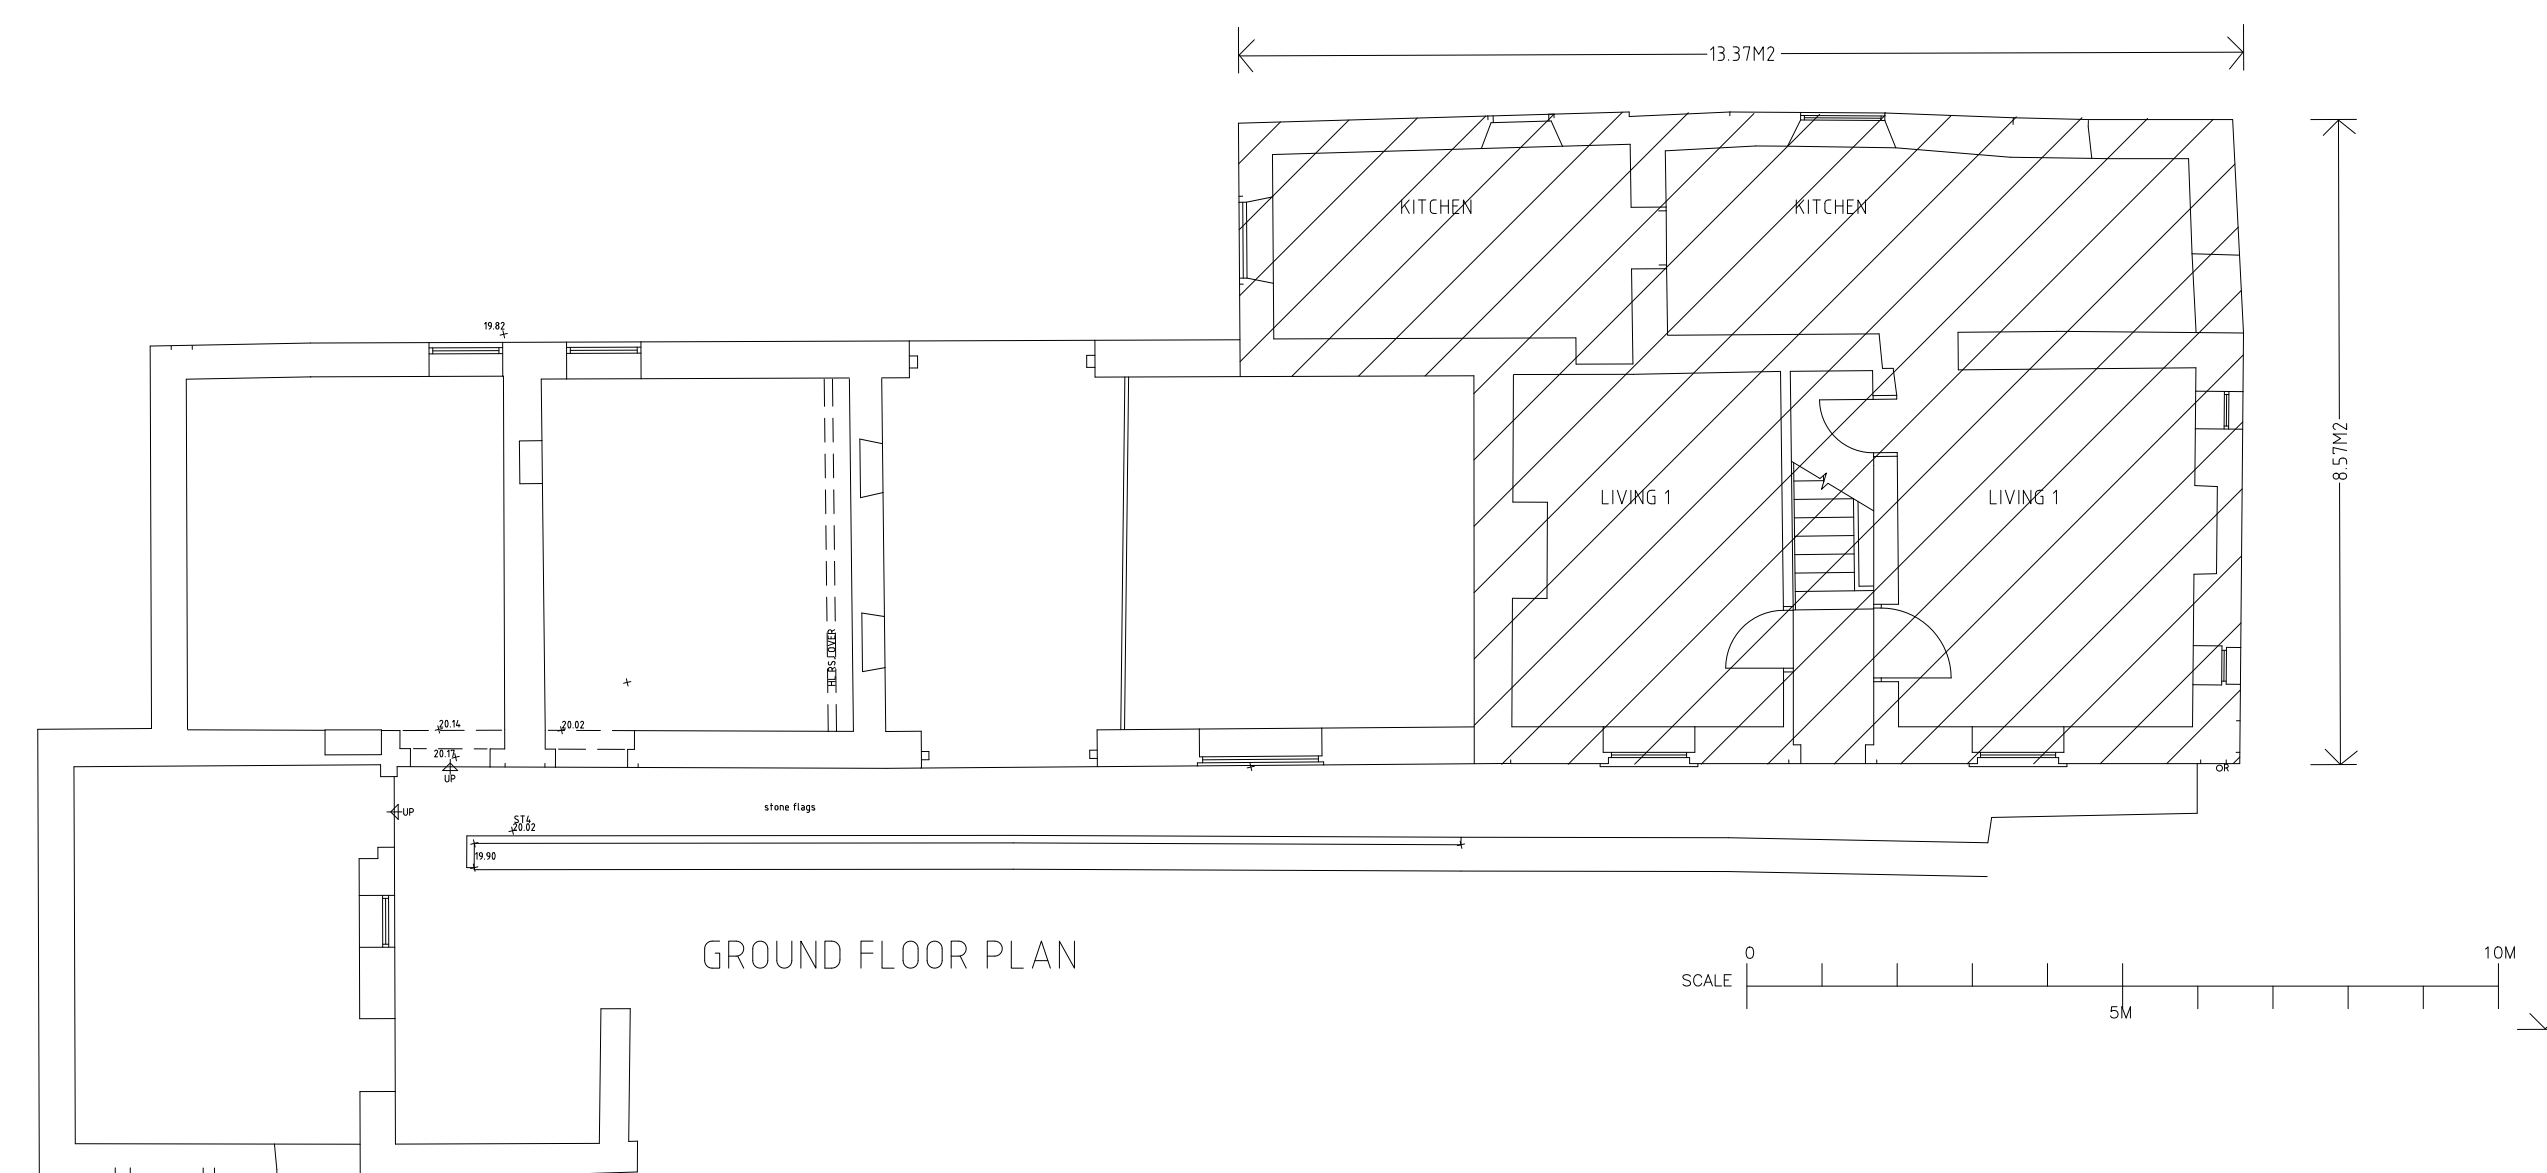

PAUL KOREN LTD
Charter House, Coley Lane,
Little Haywood, Staffordshire, ST18 0UP.
Telephone 01889-882846



CLIENT
MR.R.ALLEN
PROJECT
MEADOWS FARM
MELLOR
NR STOCKPORT
SK6 5NG
DRAWING
PLANNING EXISTING
DATE
JULY 2016
NUMBER
0782 - 50
SCALE
1:100@A1
AMENDMENT

AFFIX	AMENDMENT	DATE
A	VOLUME OF EXTENSIONS REDUCED	14.04.18
B	FULL PLAN OF EXISTING LEAN-TO	24.04.18
C	2ND ROOFLIGHT ADDED TO SHOW	25.04.19
D	AS BUILT REVISIONS TO THE PROPOSED EXTENSIONS	18.03.20

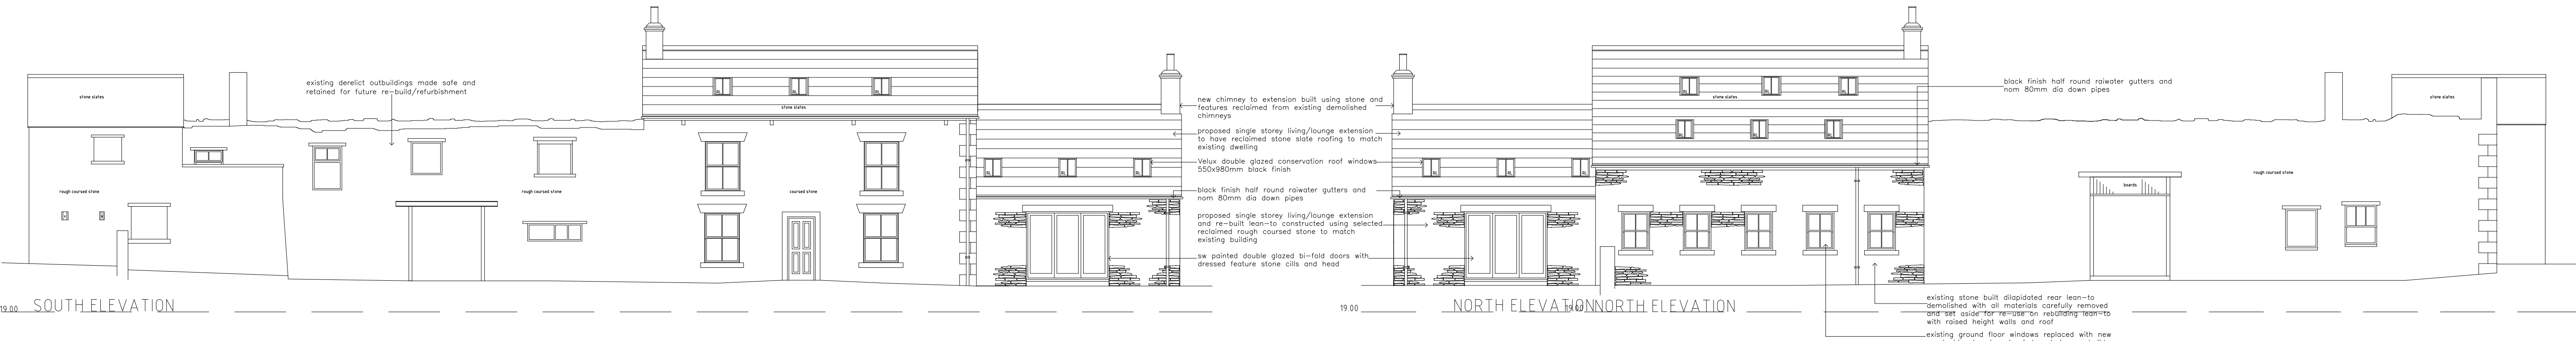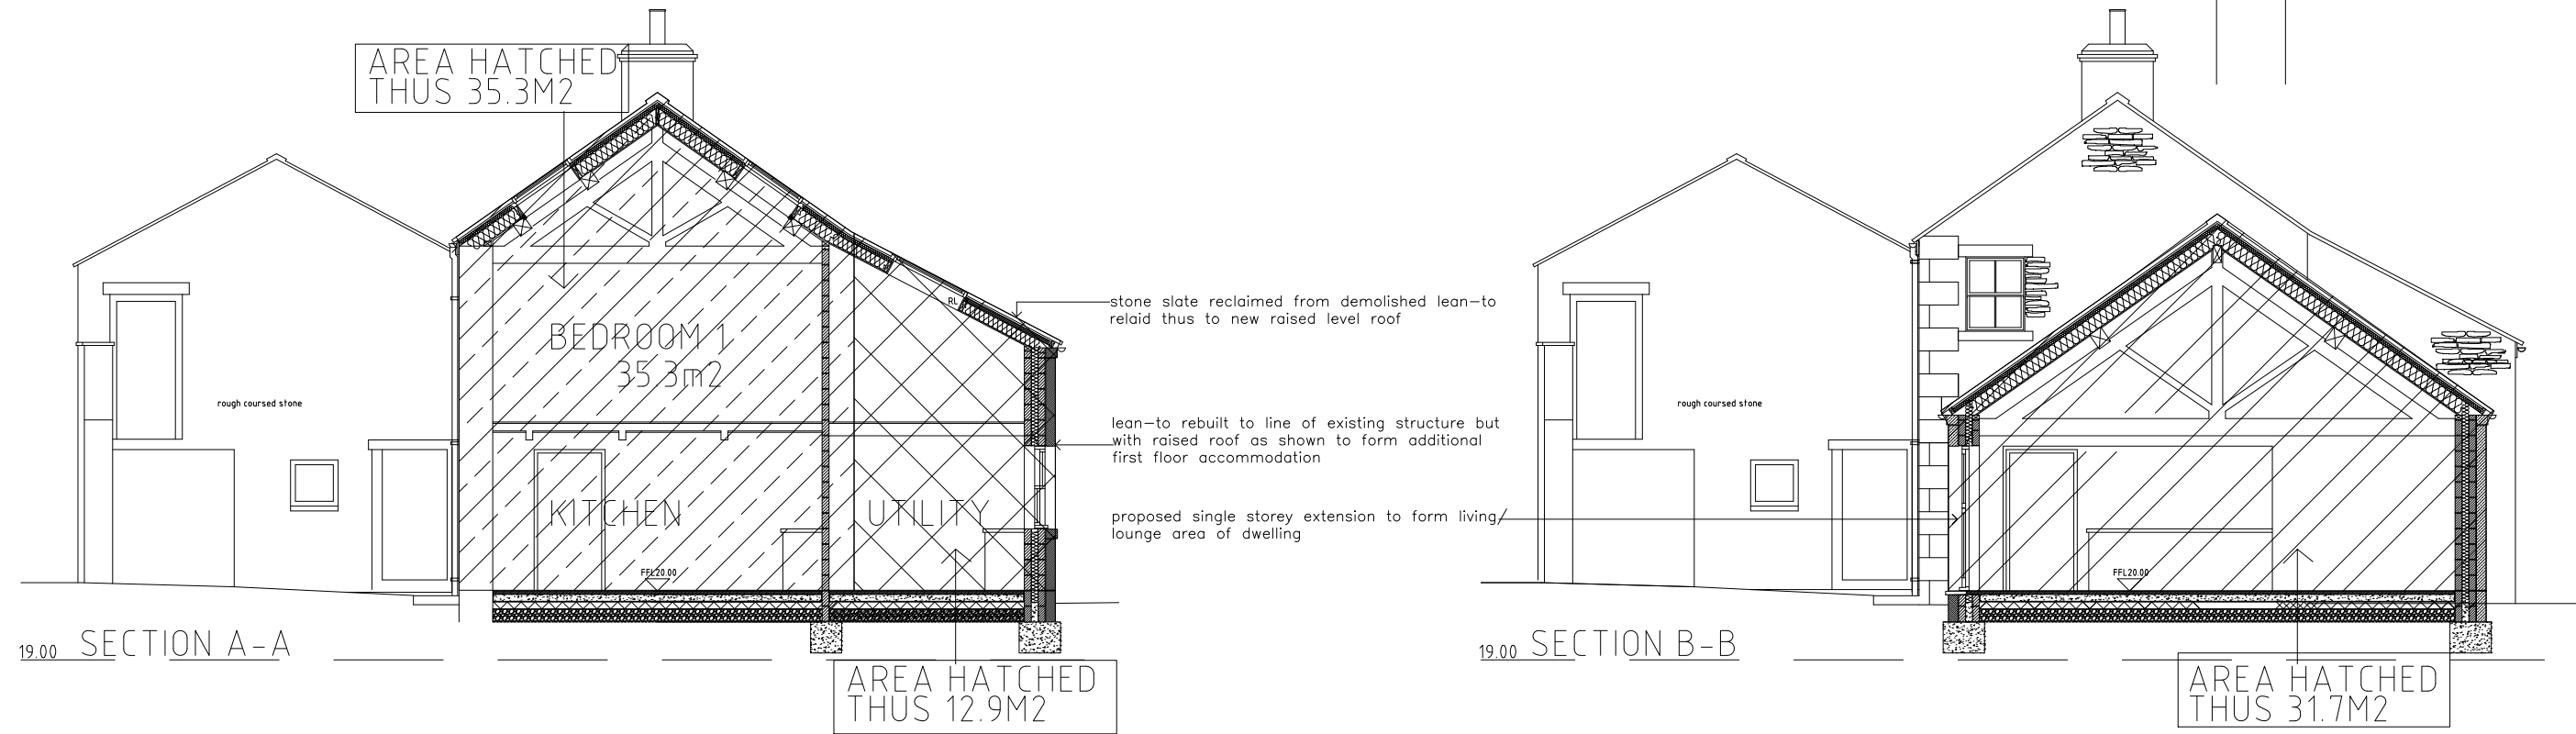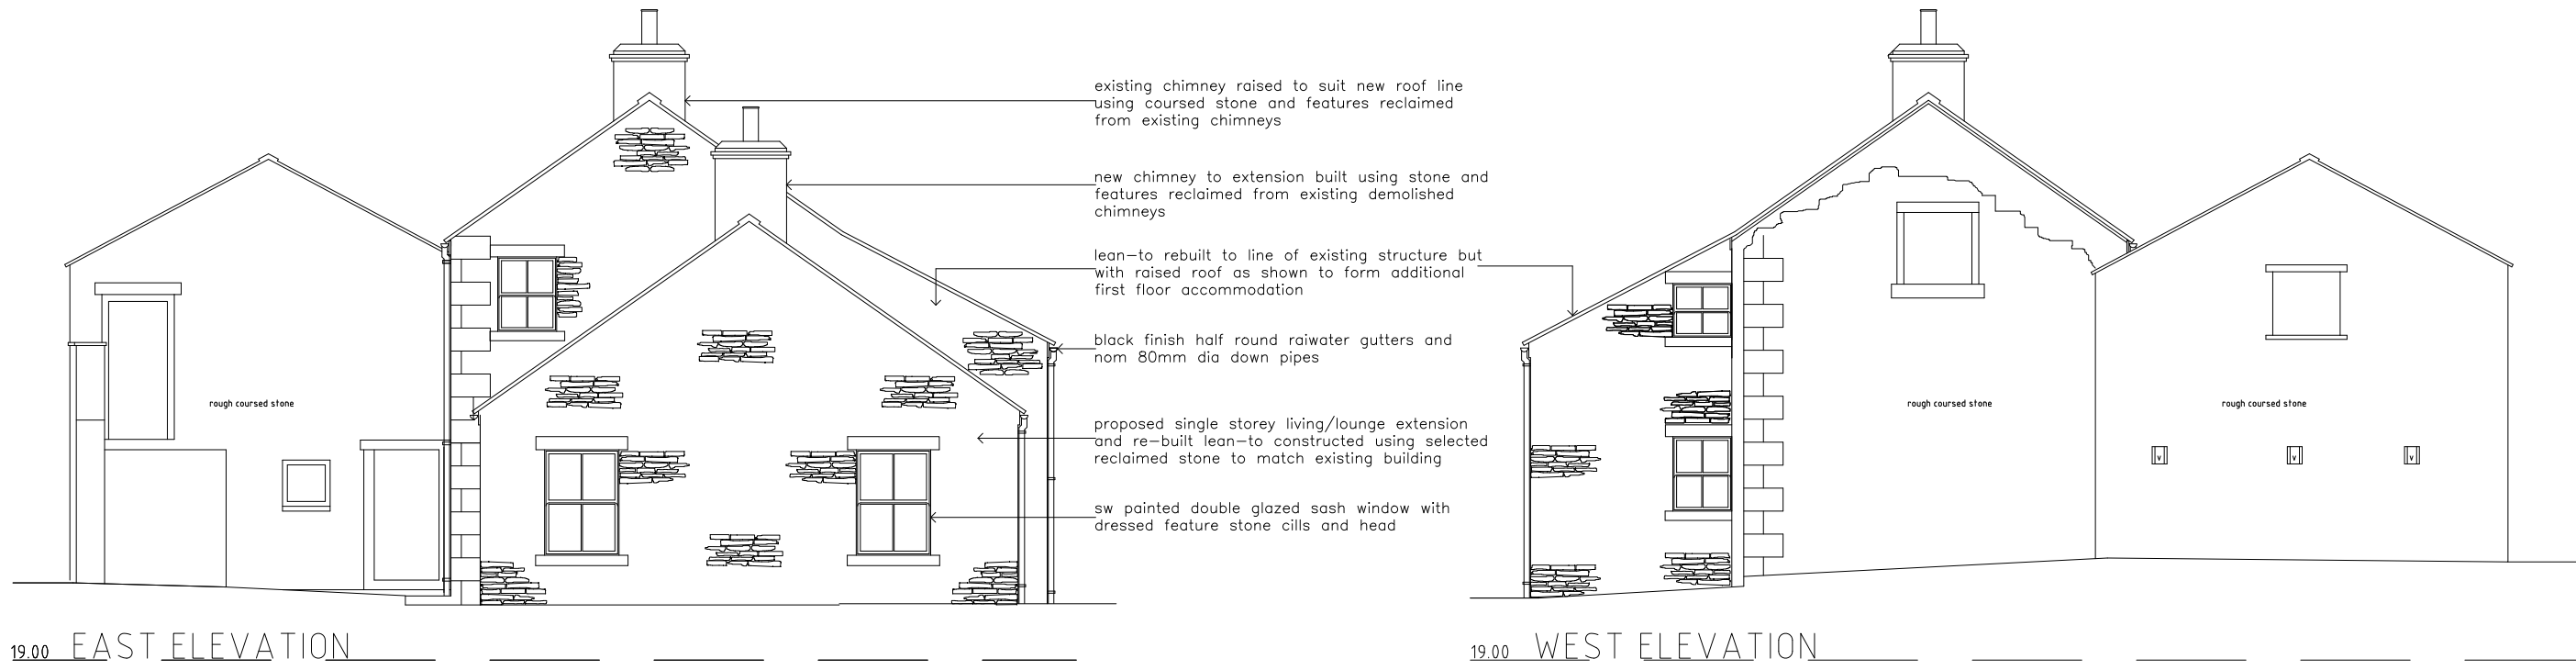

VOLUME CALCULATIONS

VOLUME OF TWO STOREY	$10.2 \times 35.3 = 360.0\text{m}^3$
VOLUME OF REBUILT LEAN-TO	$10.15 \times 12.9 = 130.9\text{m}^3$
VOLUME NEW SINGLE STOREY	$6.28 \times 31.7 = 199.0\text{m}^3$
TOTAL VOLUME AS PROPOSED	689.9M3

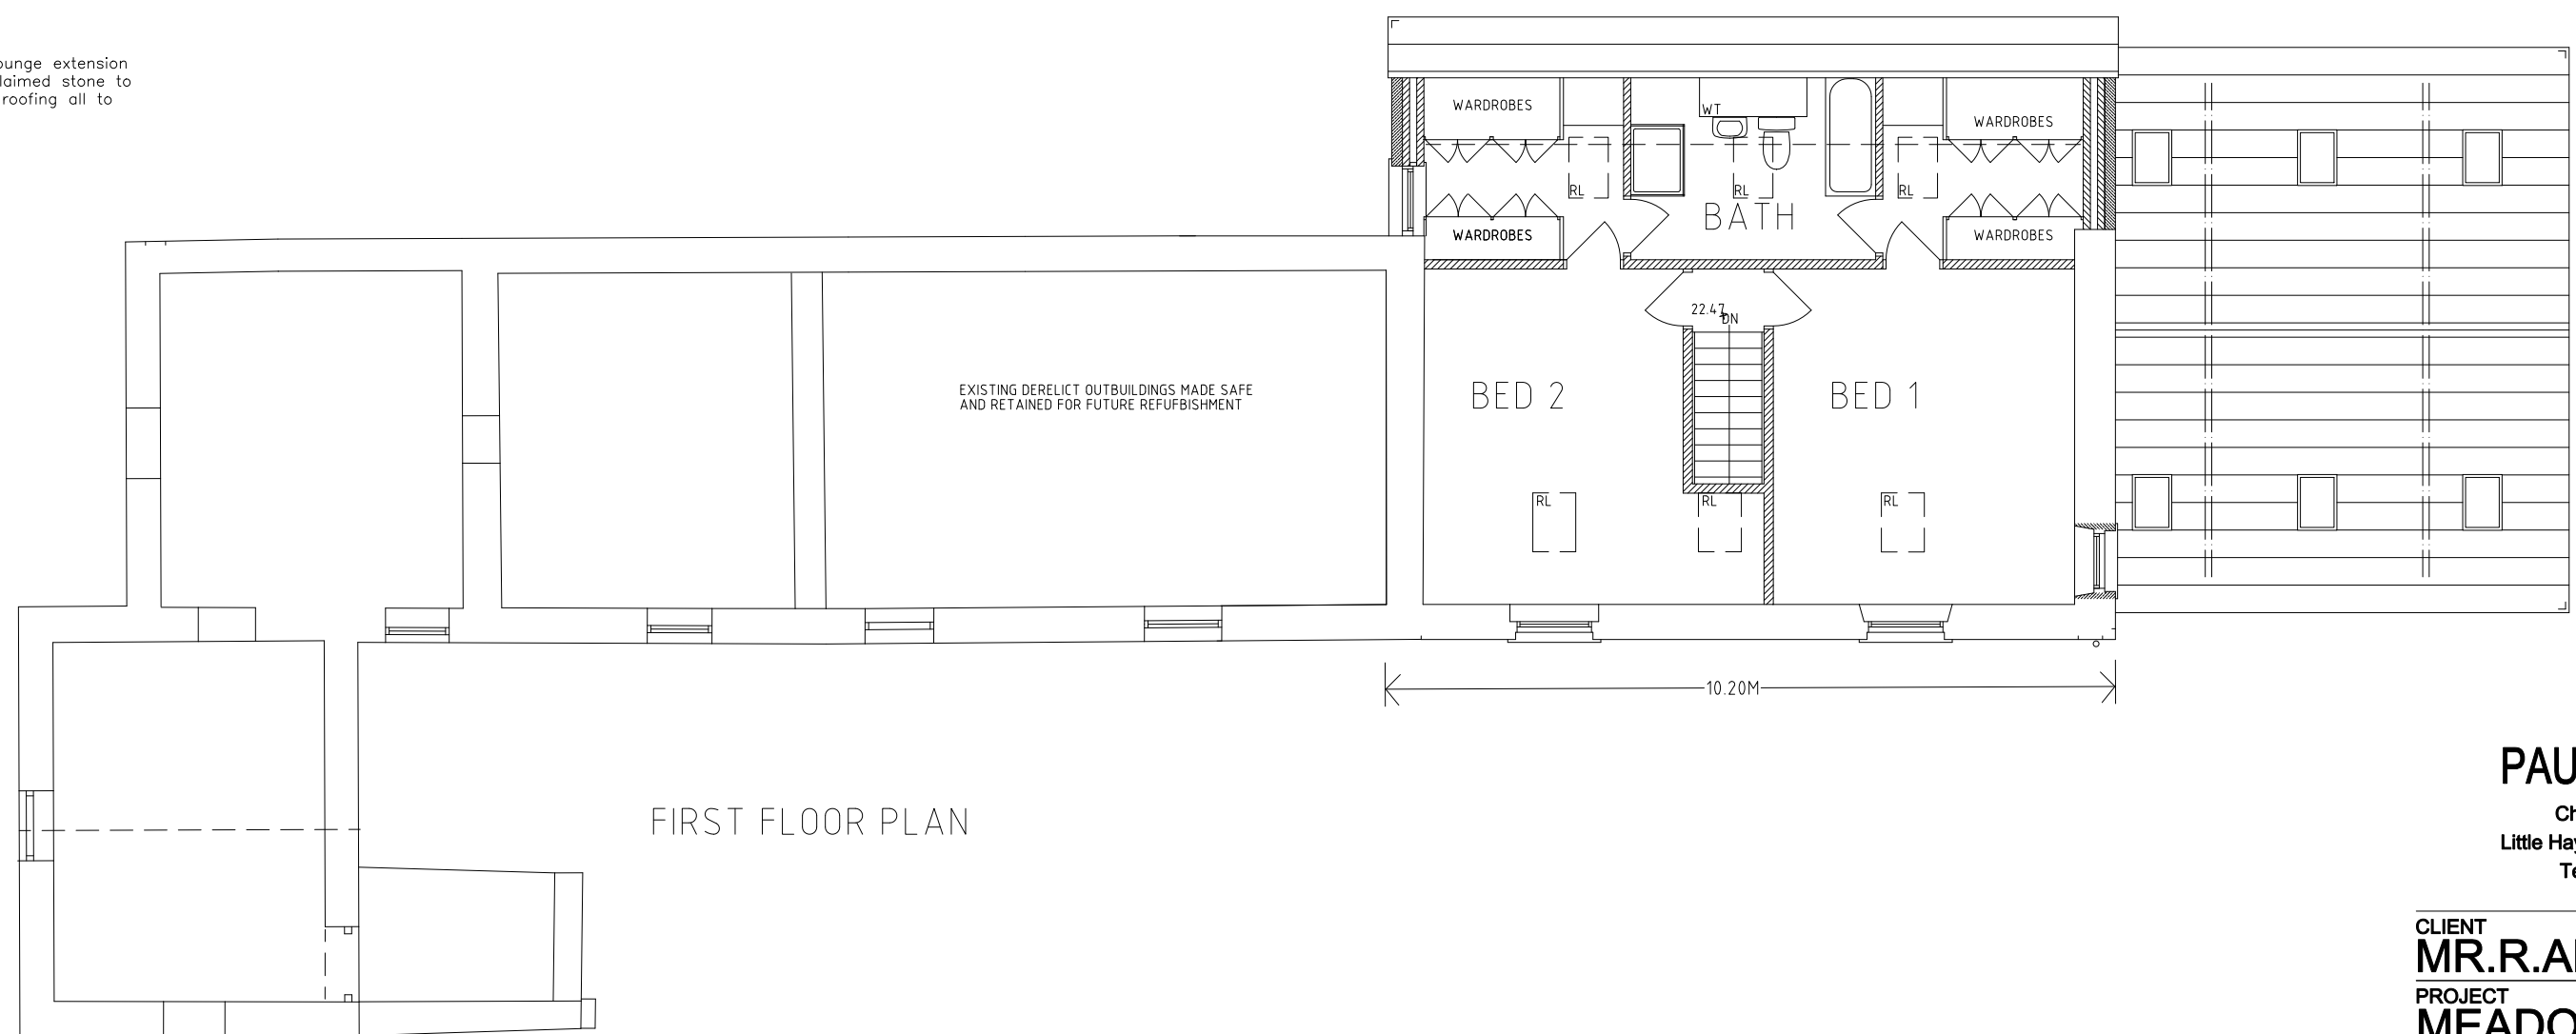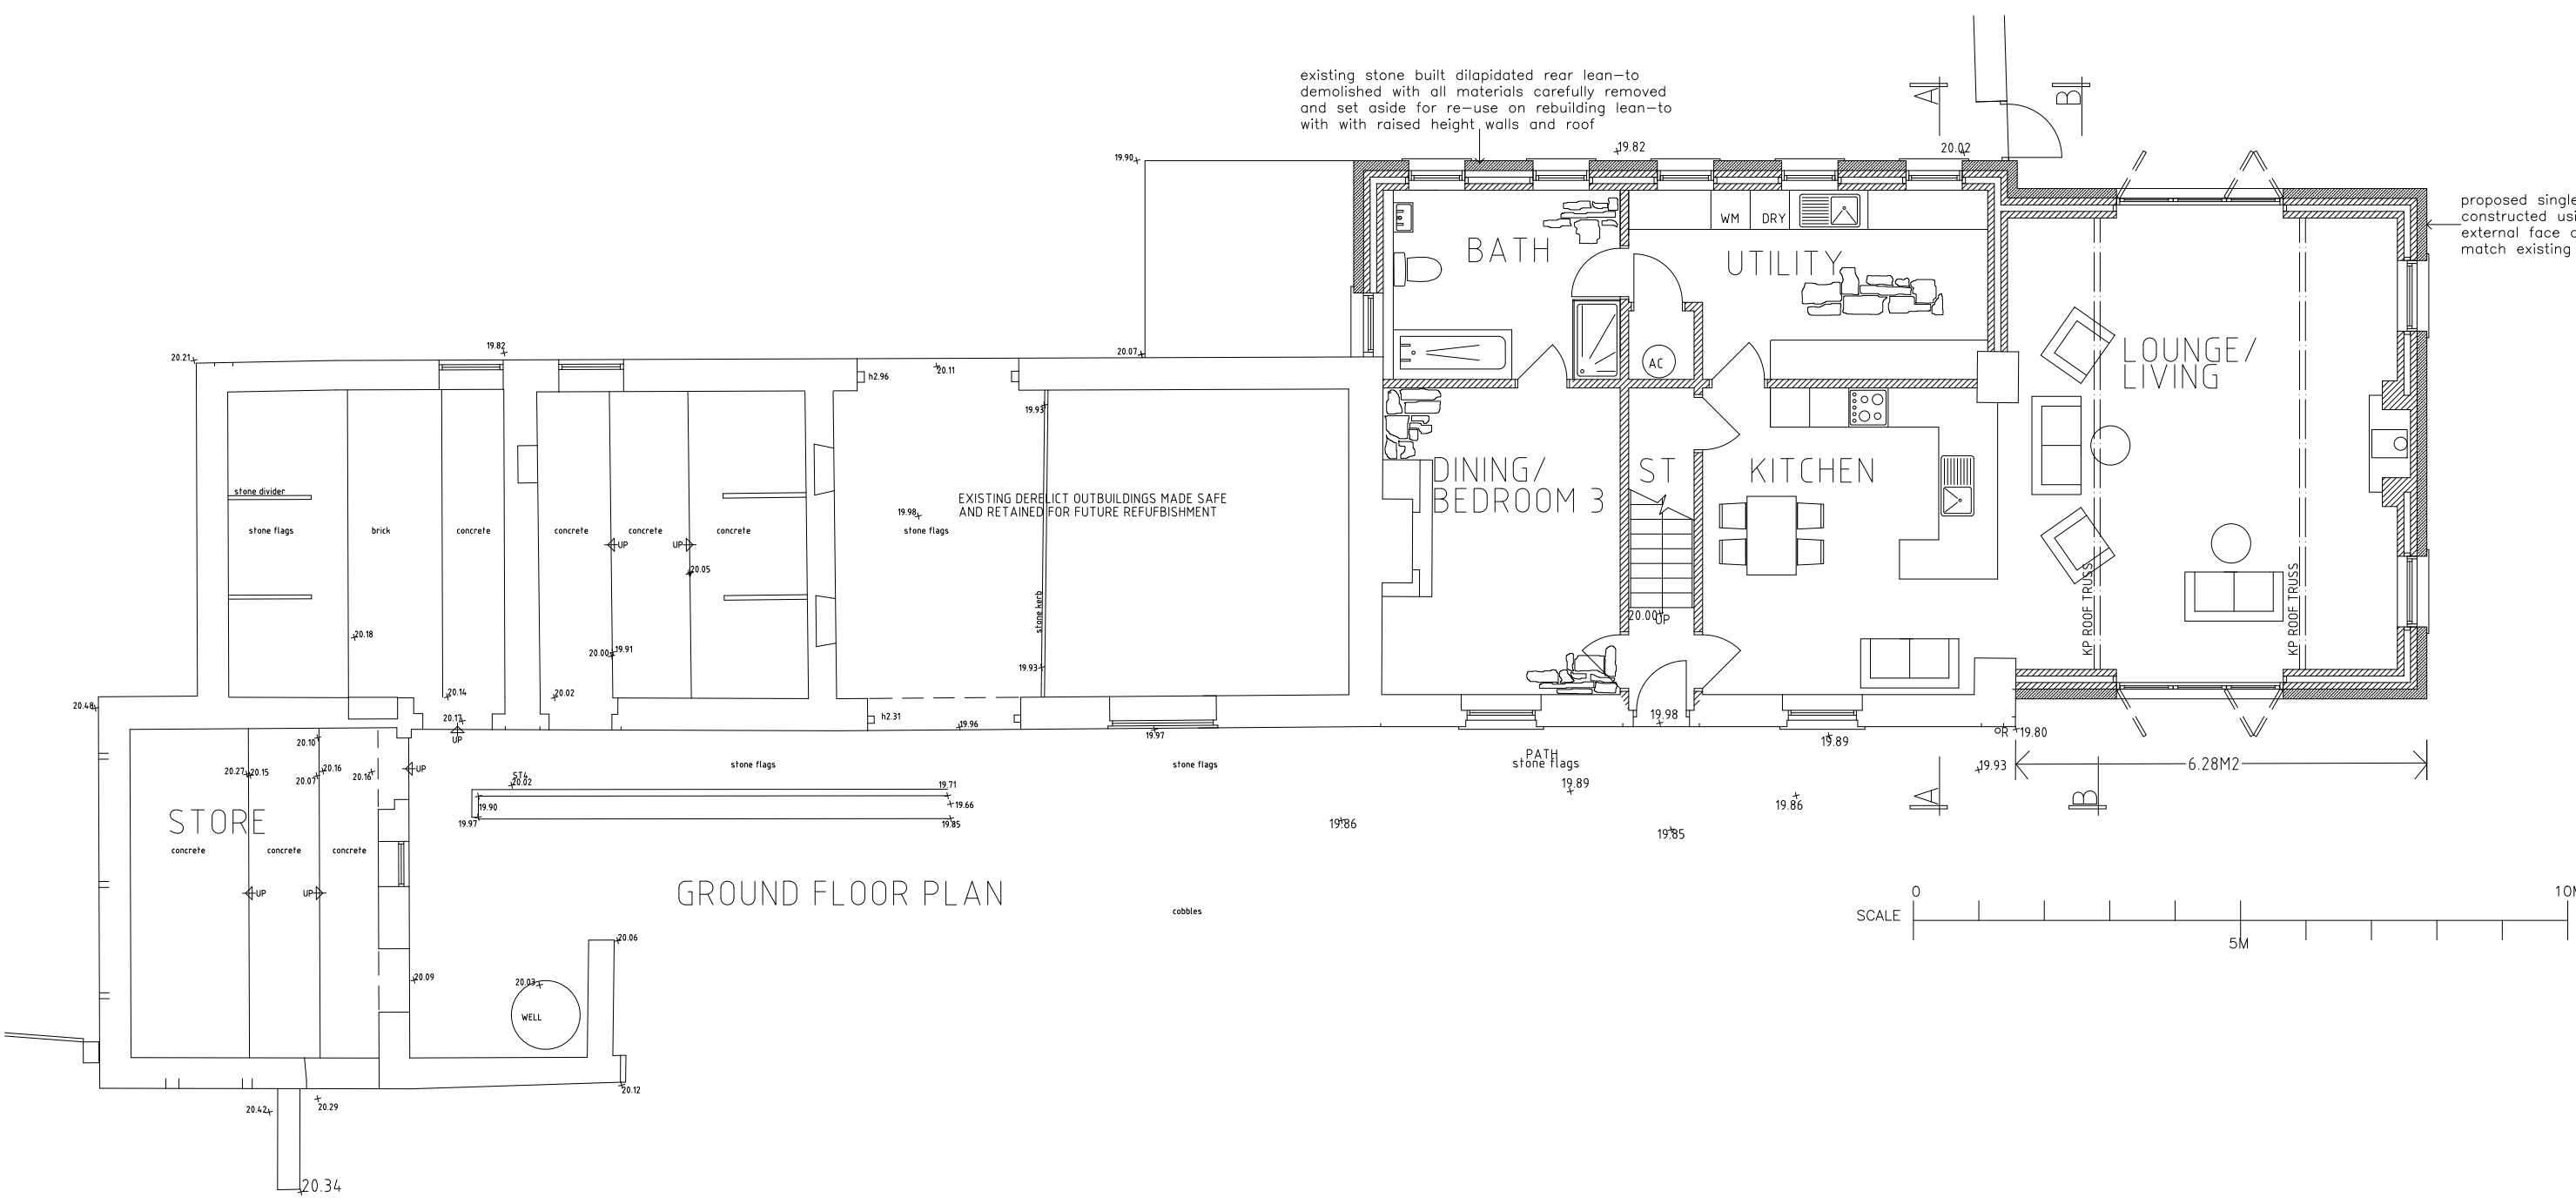

PAUL KOREN LTD
Charter House, Coley Lane,
Little Haywood, Staffordshire, ST18 0UP.
Telephone 01889-882846

CLIENT
MR.R.ALLEN

PROJECT
**MEADOWS FARM
MELLOR
NR STOCKPORT
SK6 5NG**

DRAWING
PLANNING PROPOSED

DATE
JAN 2018

NUMBER
0782 - 51

SCALE
1:100@A1

AMENDMENT
D