


This map is reproduced from Ordnance Survey material with the permission of Ordnance Survey on behalf of the Controller of Her Majesty's Stationery Office © Crown copyright. Unauthorised reproduction infringes Crown copyright and may lead to prosecution or civil proceedings. Stockport Metropolitan Borough Council 100019571 2020



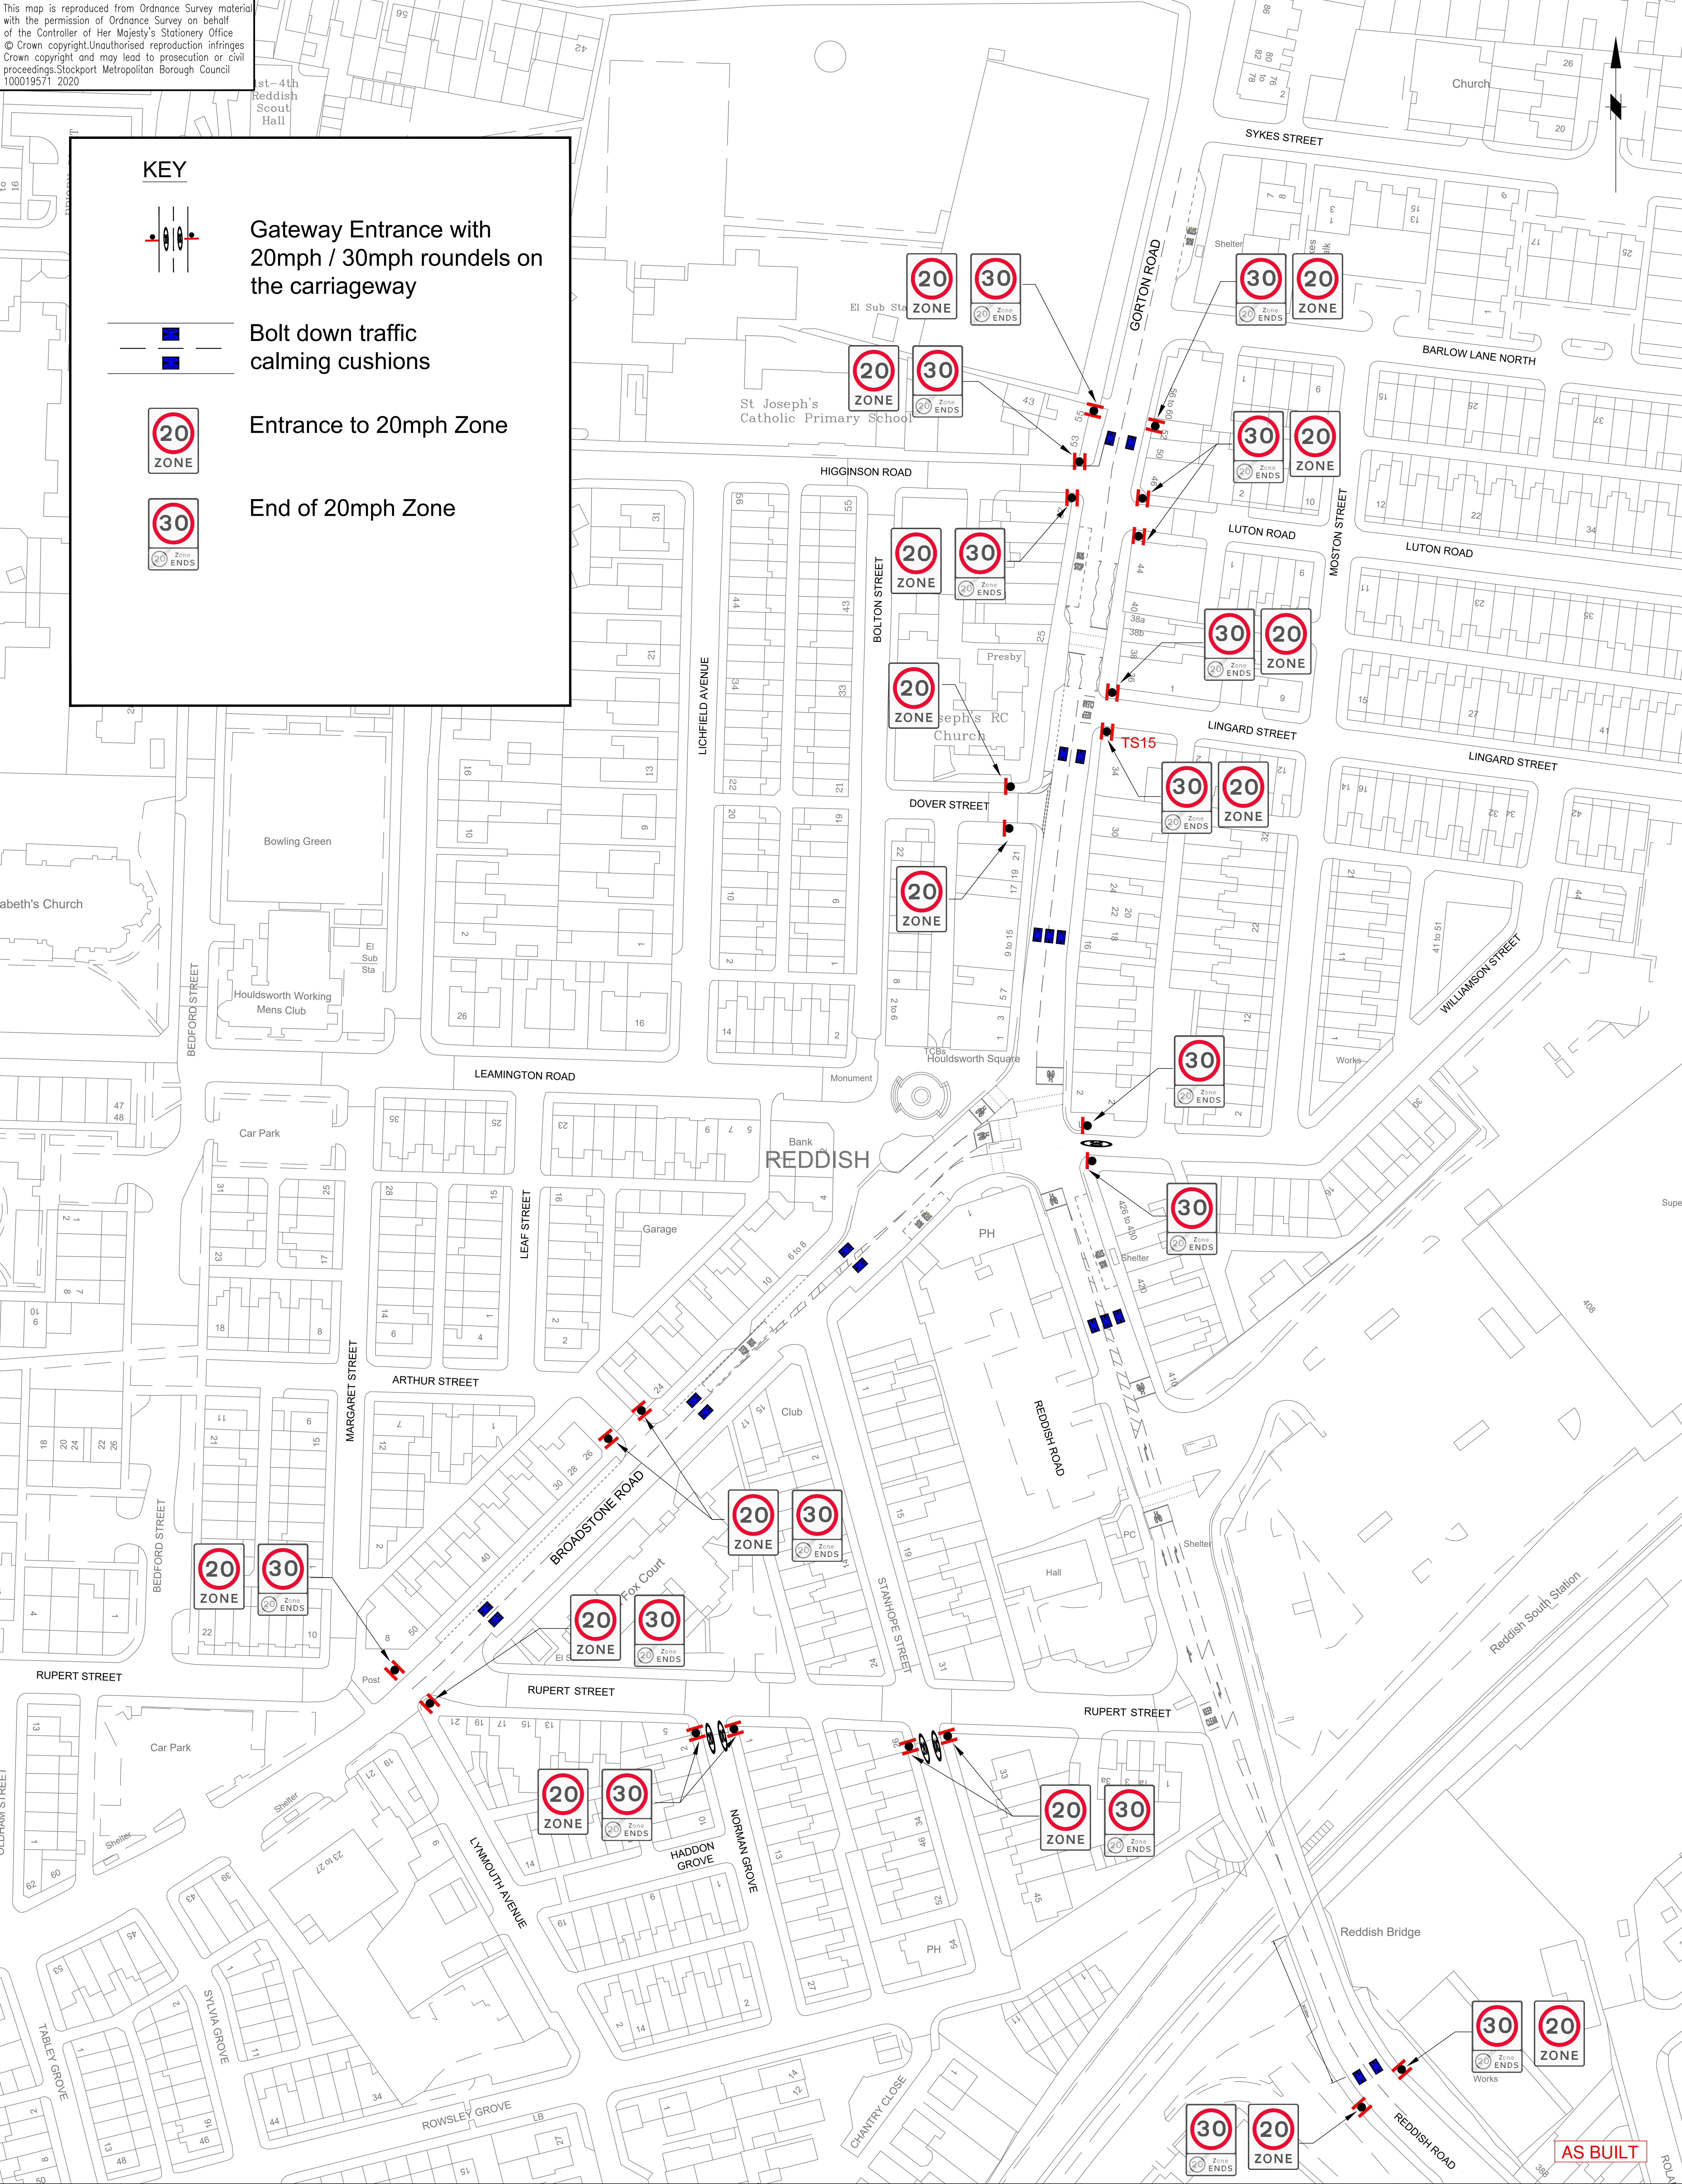

STOCKPORT

METROPOLITAN BOROUGH COUNCIL

HIGHWAYS AND TRANSPORTATION
STOFFORD HOUSE
STOCKPORT SK1 3XE
Tel: 0161 474

Rev	CP	Drawn	Checked	Date	01/02/21	AS BUILT
Revision Details						

CAROLINE SIMPSON
CORPORATE DIRECTOR
PLACE

JOB TITLE

DRAWN	CP	ENGINEER	SL	CHECKED	NDW	APPROVED	JB
DATE	27/05/2020	DATE	27/05/2020	DATE	27/05/2020	DATE	10/07/2020
SCALE						1:500	
DRAWING NUMBER						7000A2 / 7012 (D6) / HOULDSWORTH SQ, REDDISH / 01	
DRAWING TITLE						PROPOSED MEASURES GENERAL LAYOUT	

Revision ZA